



**US Army Corps
of Engineers**
Portland District

PUBLIC NOTICE

for PERMIT APPLICATION

Issue Date: September 23, 2004

Expiration Date: October 25, 2004

Corps of Engineers Action ID: 200400522

30 Day Notice

Oregon Department of State Lands Number: 32892-FP

Interested parties are hereby notified that an application has been received for a Department of the Army permit for certain work in waters of the United States, as described below and shown on the attached plan.

Comments: Comments on the described work should reference the U.S. Army Corps of Engineers number shown above and should reach this office no later than the above expiration date of this Public Notice to become part of the record and be considered in the decision. Comments should be mailed to the following address:

U.S. Army Corps of Engineers
ATTN: CENWP-OP-GP (Ms. Karla G. Ellis)
P.O. Box 2946
Portland, Oregon 97208-2946

Applicant: Mr. Andrew Kennedy
PO Box 1187
Astoria, Oregon 97103

Location: The project is located in wetlands adjacent to the Pacific Ocean south of Camp Rilea, and north of Sunset Lake, in Section 9, Township 7 North, Range 10 West, near Warrenton, Clatsop County, Oregon.

Project Description: The proposed project involves developing a 16-lot subdivision. The lots have been configured in two north-south facing groups. Lots 1 through 7 and associated access road are west of the freshwater wetland extending south from Slusher Lake. Lots 8 through 18 and Grand Avenue are located on the east side of this wetland. Approximately 0.94 acre of waters of the U.S. will be permanently filled for access roads associated with the residential development. The residential lots themselves do not require any fill within waters of the U.S. The proposed project is as follows:

- 1) Approximately 115 cubic yards of material would be placed in wetlands to create driveway access to lot #7. Fill material would consist of sand and crushed gravel.
- 2) Approximately 420 cubic yards of material would be placed to allow for creation of a cul-de-sac to access the residential properties on the northern end of the project site.
- 3) Approximately 1,965 cubic yards of sand and crushed rock would be placed for a wetland crossing to be known as Park Avenue. A single culvert would be installed at the low point of the roadway to maintain the connection of the wetlands. The crossing is located between lots 14 and 15 on the eastern side and lots 1 and 2 on the western side of the site, and would measure 40 to 50 feet wide.

- 4) Approximately 1,180 cubic yards of sand and crushed rock would be placed immediately east of the subdivision near lot 14 for the connection of Park Avenue to the existing off-site road system. The roadway would measure 40 to 50 feet wide. A single culvert would be installed at the low point of the roadway to maintain the connection of the wetlands.

Note:

- 1) Runoff from impervious surfaces will be routed to sandy upland areas, where it will percolate into the soil and the water table.
- 2) The total project would involve placing 3,680 cubic yards of material in wetlands, permanently impacting 0.94 acre of waters of the U.S.

If a permit is issued, the Corps will determine what is appropriate and practicable compensatory mitigation. The amount of compensatory mitigation required shall be commensurate with the anticipated impacts of the project.

Purpose: The purpose of the project is to develop a 16-lot rural residential subdivision, utilities, and access roads.

Drawings: 11 Drawings Labeled Corps #200400522

Additional Information: Additional information may be obtained from Ms. Karla G. Ellis, Project Manager, U.S. Army Corps of Engineers at (503) 808-4377.

Authority: This permit will be issued or denied under the following:

Section 404, Clean Water Act (33 U.S.C. 1344), for discharge of dredged or fill material into waters of the United States.

Water Quality Certification: A permit for the described work will not be issued until certification, as required under Section 401 of the Clean Water Act (P.L. 95-217), has been received or is waived from the certifying state. Attached is the state's notice advertising the request for certification.

Section 404(b)(1) Evaluation: The impact of the activity on the public interest will be evaluated in accordance with the Environmental Protection Agency guidelines pursuant to Section 404(b)(1) of the Clean Water Act.

Coastal Zone Management Act Certification: A permit for the described work will not be issued until the state has concurred with the applicant's certification that the described activity affecting land or water uses in the Coastal Zone complies with the State Coastal Zone Management Program. Section 307(c)(3) of the Coastal Zone Management Act of 1972, as amended by 16 U.S.C. 1456(c)(3) requires the applicant to provide a Certification of Consistency statement. If the state fails to concur or object to the certification statement within six months, state concurrence shall be conclusively presumed. Attached to this Public Notice is a notice of application for Certification of Consistency with the State's Coastal Zone Management Program.

Public Hearing: Any person may request, in writing, within the comment period specified in this notice, that a public hearing be held to consider this application. Requests for public hearings shall state, with particularity, the reasons for holding a public hearing.


Endangered Species: Preliminary determinations indicate that the described activity will not affect endangered species, or their critical habitat designated as endangered or threatened, under the Endangered Species Act of 1973 (87 Stat. 844). Formal consultation under Section 7 of the Act is not required for the described activity.

Cultural Resources: The described activity is not located on property registered or eligible for registration in the latest published version of the National Register of Historic Places. This notice has been provided to the State Historic Preservation Office.

Evaluation: The decision whether to issue a permit will be based on an evaluation of the probable impact including cumulative impacts of the described activity on the public interest. That decision will reflect the national concern for both protection and utilization of important resources. The benefit, which reasonably may be expected to accrue from the described activity, must be balanced against its reasonably foreseeable detriments. All factors, which may be relevant to the described activity will be considered including the cumulative effects thereof; among those are conservation, economics, aesthetics, general environmental concerns, wetlands, historic properties, fish and wildlife values, flood hazards, floodplain values, land use, navigation, shoreline erosion and accretion, recreation, water supply and conservation, water quality, energy needs, safety, food and fiber production, mineral needs, consideration of property ownership and, in general, the needs and welfare of the people.

The Corps of Engineers is soliciting comments from the public; Federal, state, and local agencies and officials; Indian Tribes; and other interested parties in order to consider and evaluate the impacts of this proposed activity. Any comments received will be considered by the Corps of Engineers to determine whether to issue, modify, condition or deny a permit for this proposal. To make this decision, comments are used to assess impacts on endangered species, historic properties, water quality, general environmental effects, and the other public interest factors listed above. Comments are used in the preparation of an Environmental Assessment and/or an Environmental Impact Statement pursuant to the National Environmental Policy Act. Comments are also used to determine the need for a public hearing and to determine the overall public interest of the proposed activity.

Additional Requirements: State law requires that leases, easements, or permits be obtained for certain works or activity in the described waters. These State requirements must be met, where applicable, and a Department of the Army permit must be obtained before any work within the applicable Statutory Authority, previously indicated, may be accomplished. Other local governmental agencies may also have ordinances or requirements, which must be satisfied before the work is accomplished.

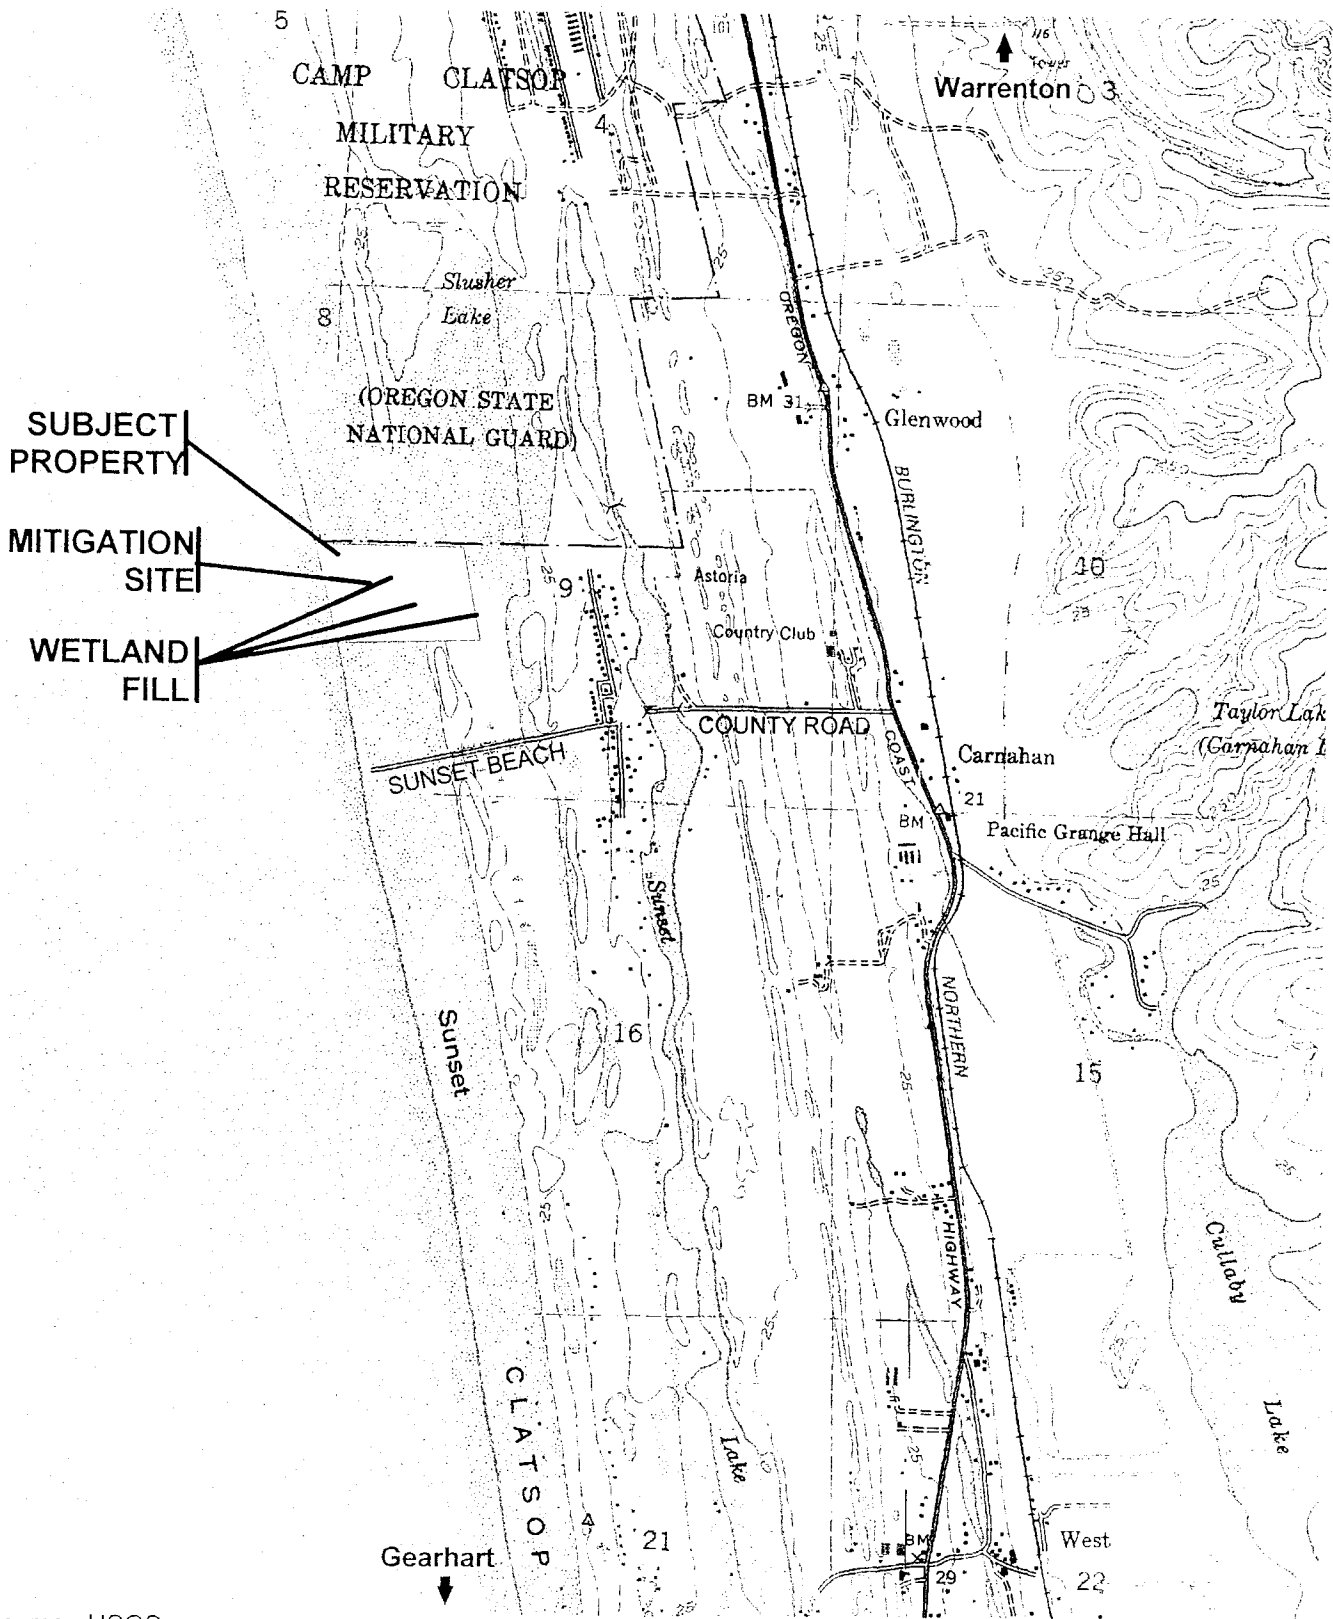

source: USGS

Location Map
Kennedy Property
Clatsop County, OR
Sheet 1

Comp #200400522


OCEAN BELLEVUE

DEVELOPER: MR. & MRS. ANDREW KENNEDY
P.O. BOX 1167
ASTORIA, OR. 97103
(503) 440-5888

ENGINEER: JB RANKIN ENGINEERING INC.
P.O. BOX 187-878 EAST HARBOR
WARRENTON, OR. 97146
(503) 861-0779

SURVEYOR: MR. KARL FOESTIE, PLS
COAST SURVEYING
P.O. BOX 807
WARRENTON, OR. 97146
(503) 861-2569

PLANNER: MR. MARK BARNES
BOO EXCHANGE
ASTORIA, OR. 97103
(503) 325-4356

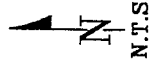


650' ±

Sheet 7

OCEAN BELLEVUE
MR. & MRS. ANDREW KENNEDY

JB RANKIN ENGINEERING INC.
P.O. BOX 187-878 EAST HARBOR
WARRENTON, OR. 97146
(503) 861-0779


SITE PLAN

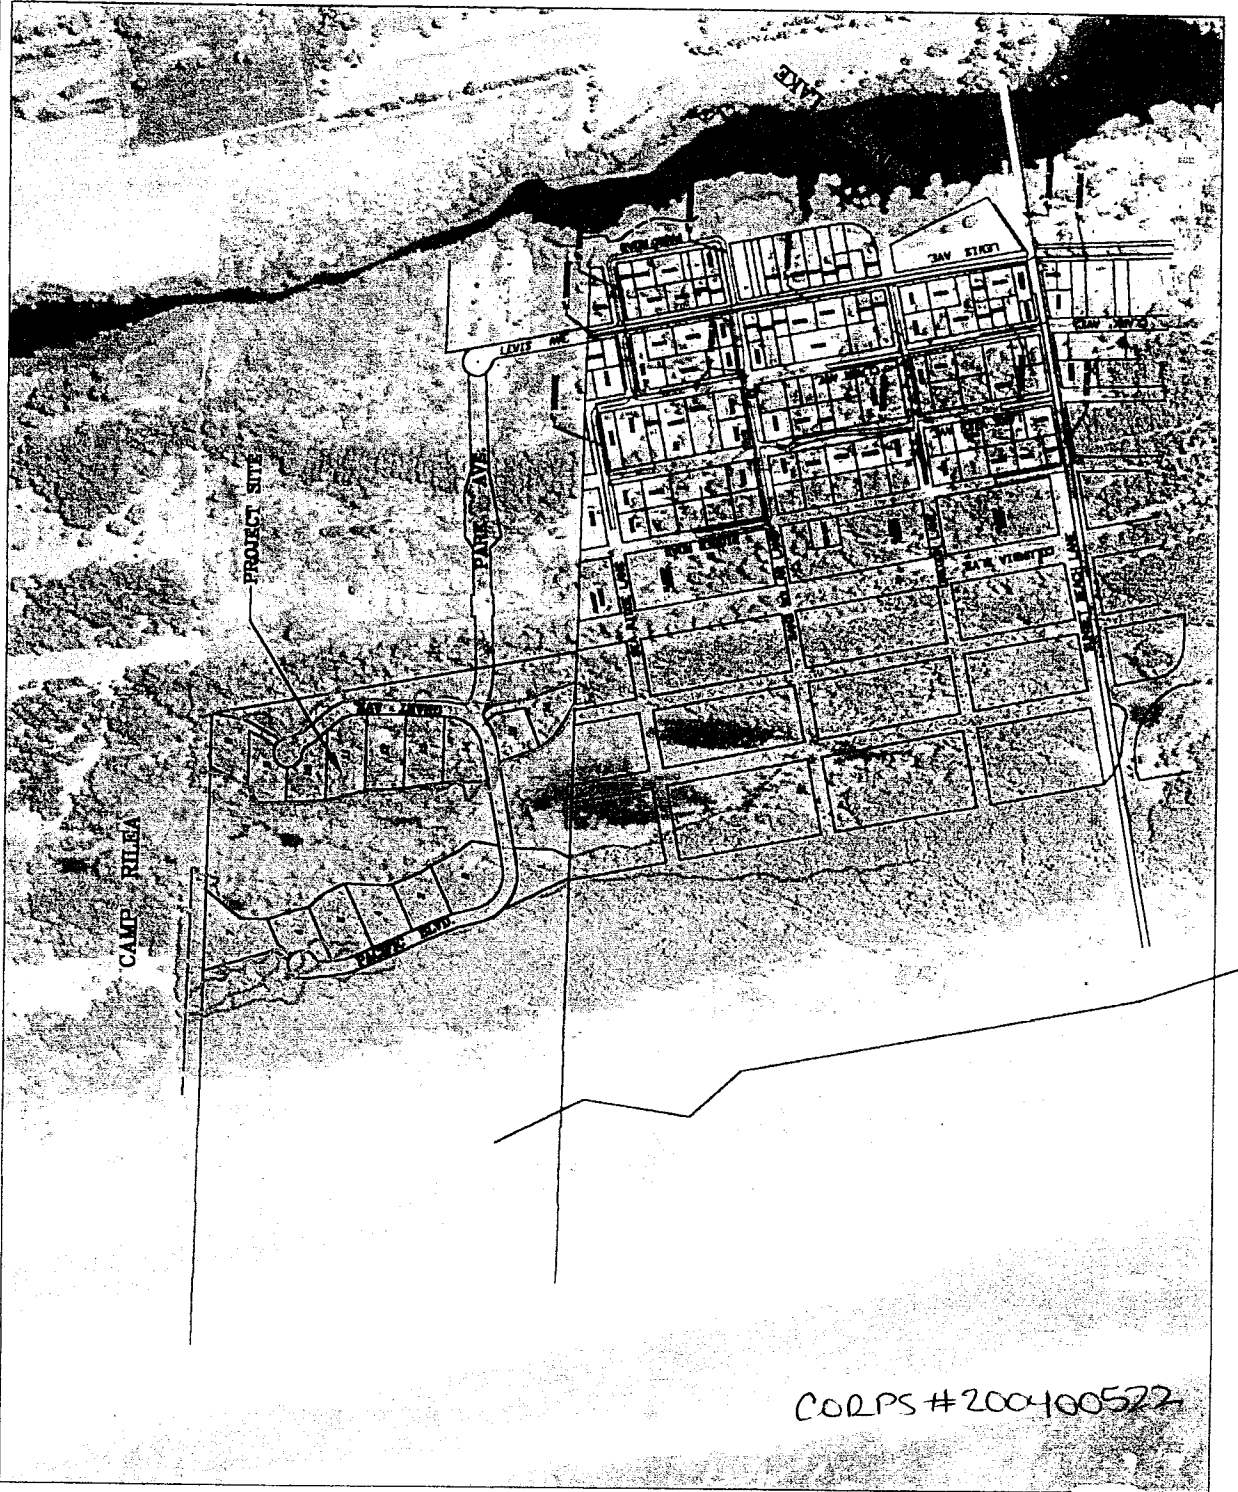

CORPS #200400522


CAMP RILEA

FENCE

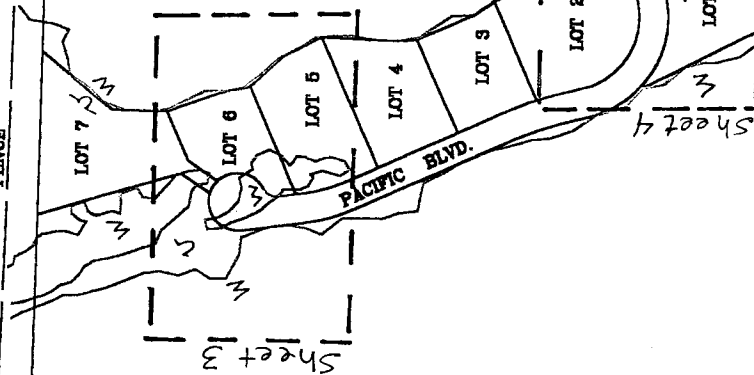

PROJECT SITE

300 ft

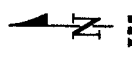

OCEAN BELLEVUE

DEVELOPER: MR. & MRS. ANDREW KENNEDY
P.O. BOX 1817
ASTORIA, OR 97103
(503) 440-8888

ENGINEER: JR. RANSON ENGINEERING INC.
P.O. BOX 187-878 EAST HARBOR
WARRENTON, OR 97146
(503) 861-0778

SURVEYOR: MR. KARL FOETIE, P.L.S.
COAST SURVEYING
P.O. BOX 807
WARRENTON, OR 97146
(503) 861-2588

PLANNER: MR. MARK BARNES
800 EXCHANGE
ASTORIA, OR 97103
(503) 325-4396



OCEAN BELLEVUE
MR. & MRS. ANDREW KENNEDY

JR. RANSON ENGINEERING INC.
P.O. BOX 187-878 EAST HARBOR
WARRENTON, OR 97146
(503) 861-0778


SITE PLAN

Sheet 2

100PS#200100522

OCEAN BELLEVUE SUBDIVISION

CROSS-SECTIONS FOR
WETLAND PERMITS
APRIL 3, 2004

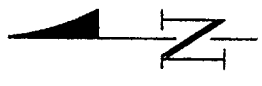

WETLAND

WETLAND/FILL
AREA=772 SF

WETLAND
BOUNDARY

WETLAND/FILL
AREA=3,788 SF

P.O.B. 0+75.00
1+06.00

2+00.00
PC 2+15.41

3+10.00
PT

PACIFIC BLVD.




WETLAND AREAS
KENNEDY PROPERTY
CLATSOP COUNTY, OR.
SHEET ~~1 OF 2~~ 3 A

Caps # 200400522

OCEAN BELLEVUE SUBDIVISION

CROSS-SECTIONS FOR
WETLAND PERMITS
APRIL 3, 2004

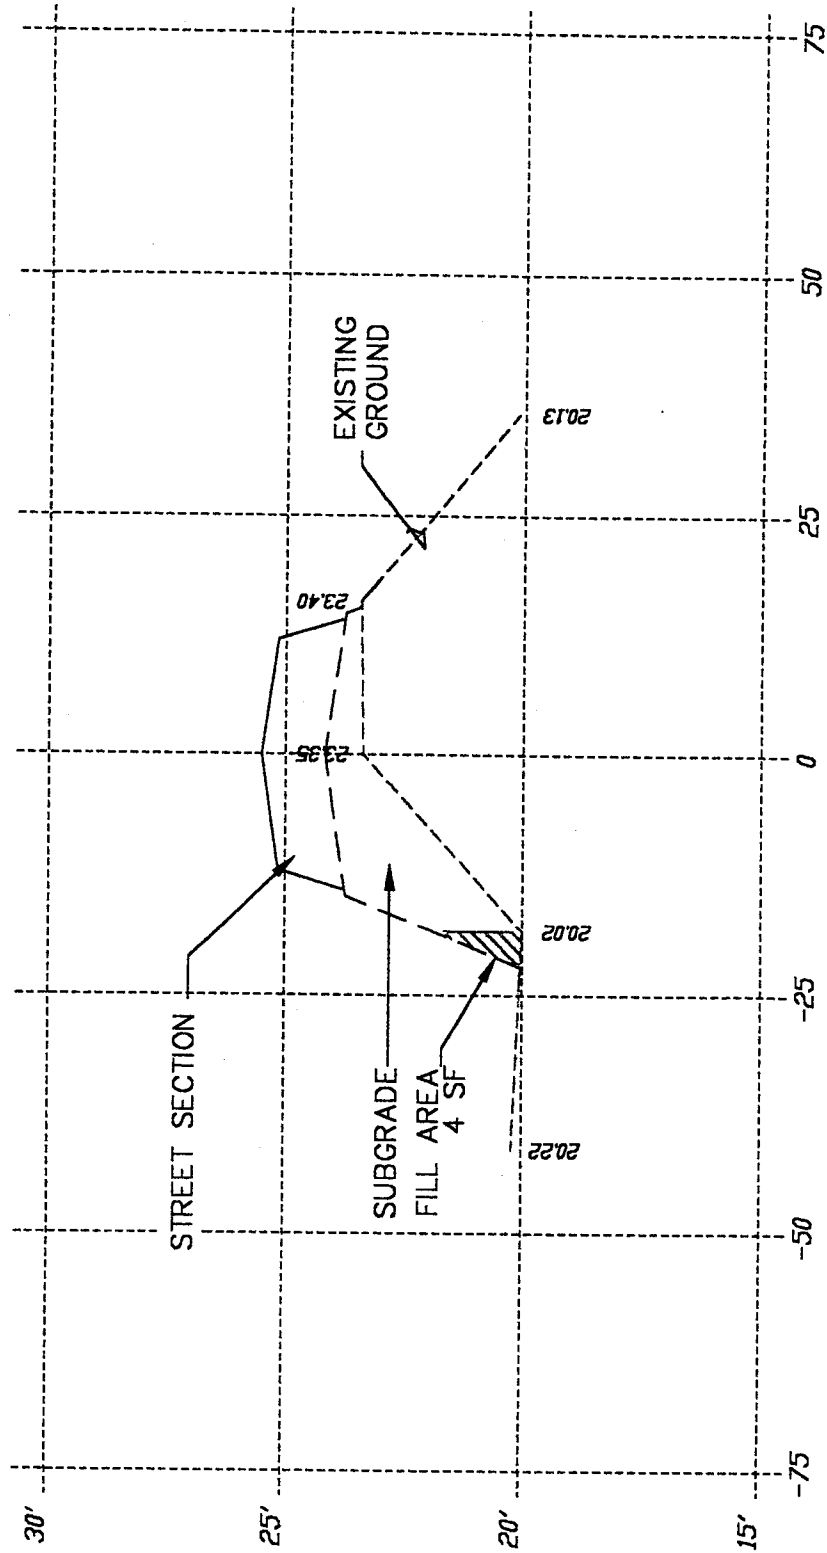


X-SECTION
KENNEDY PROPERTY
CLATSOP COUNTY, OR.
SHEET 3B

PACIFIC BLVD.
STA 1+50

Caps #200400522

OCEAN BELLEVUE SUBDIVISION

CROSS-SECTIONS FOR
WETLAND PERMITS
APRIL 3, 2004

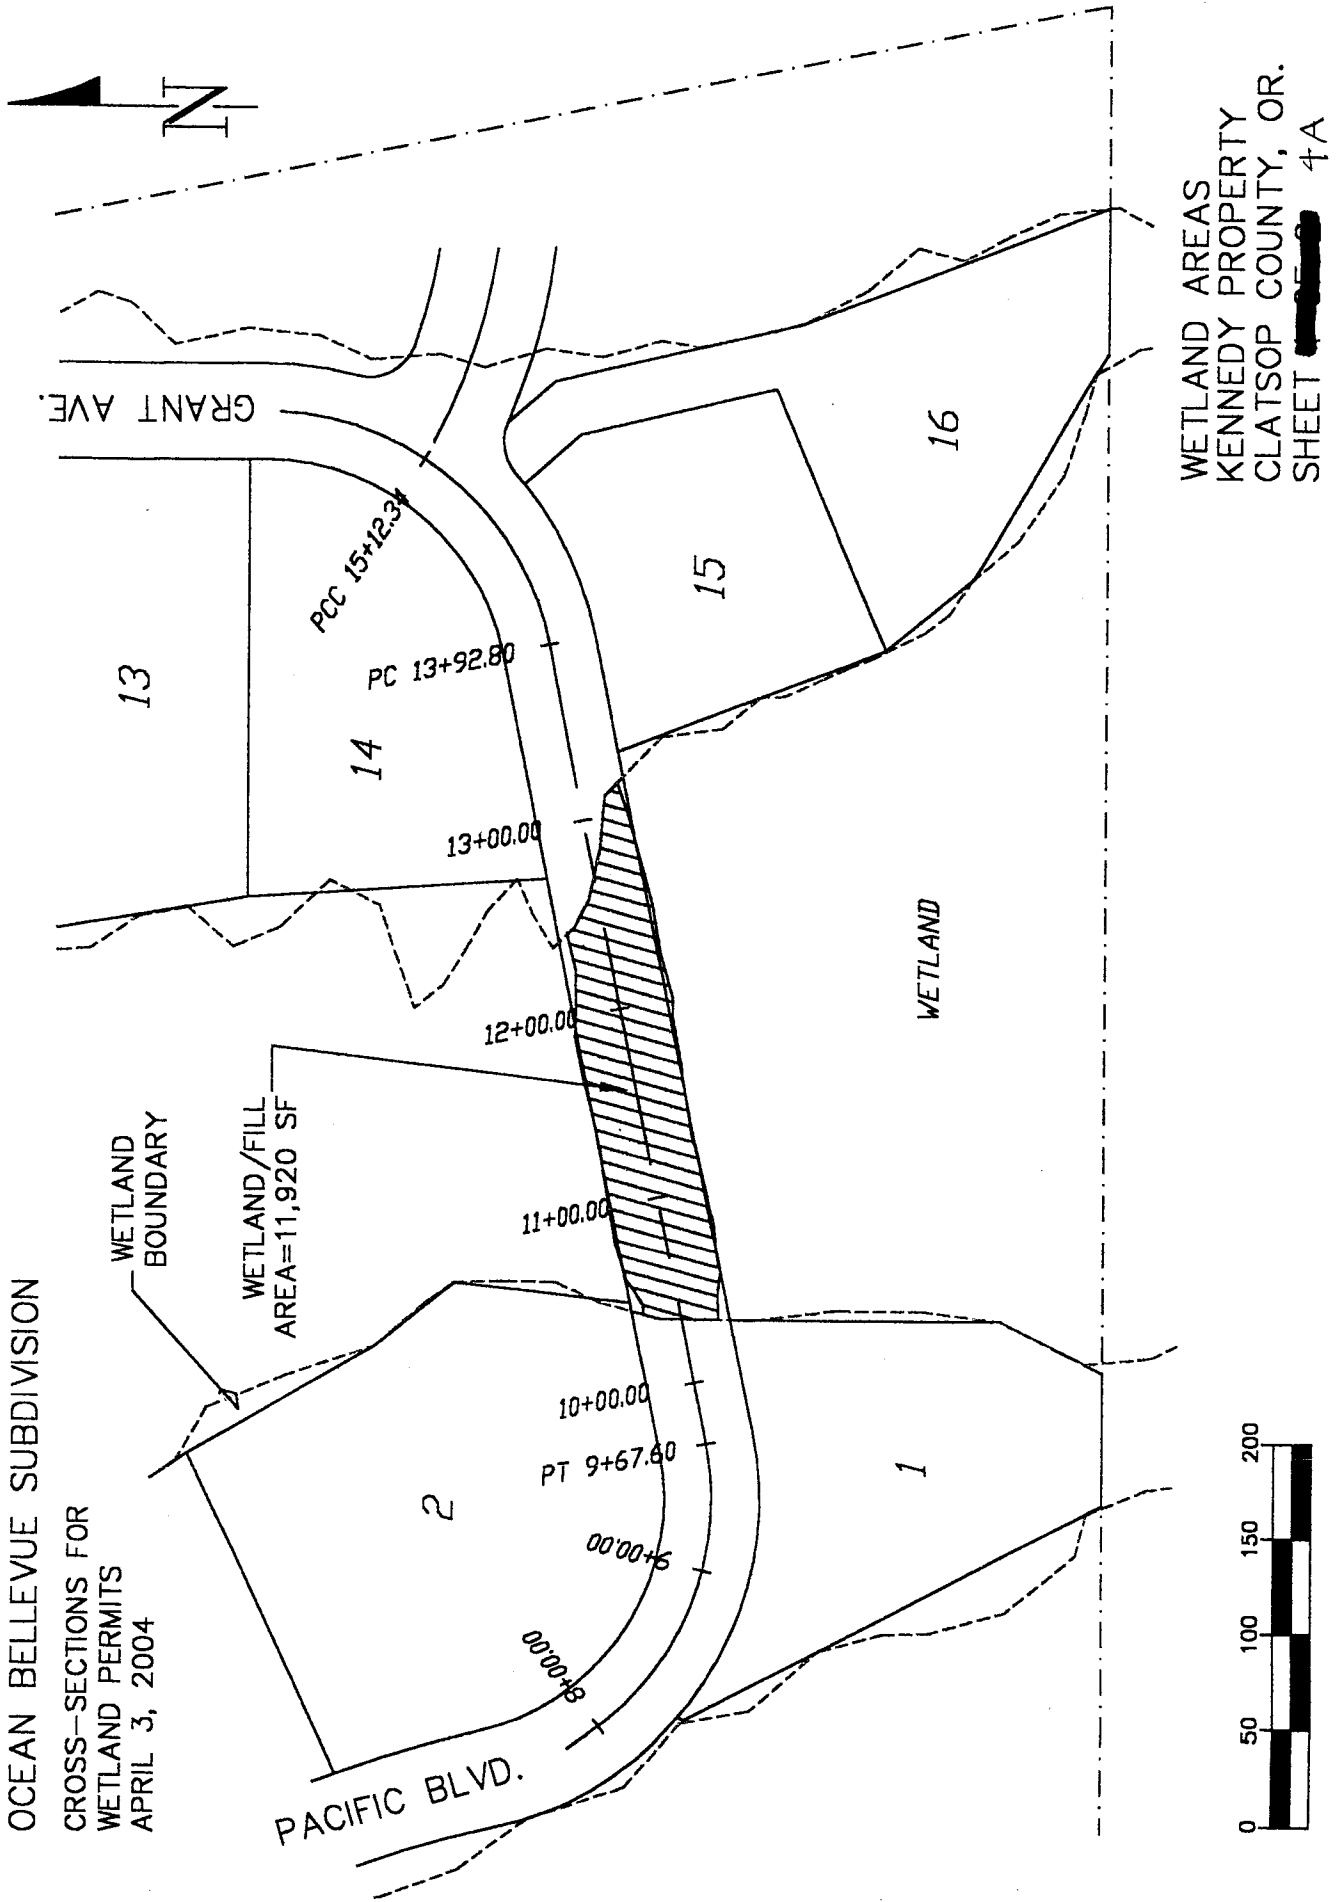


WETLAND AREAS
KENNEDY PROPERTY
CLATSOP COUNTY, OR.
SHEET 4A



Cops #200400522

OCEAN BELLEVUE SUBDIVISION

CROSS-SECTIONS FOR
WETLAND PERMITS
APRIL 3, 2004

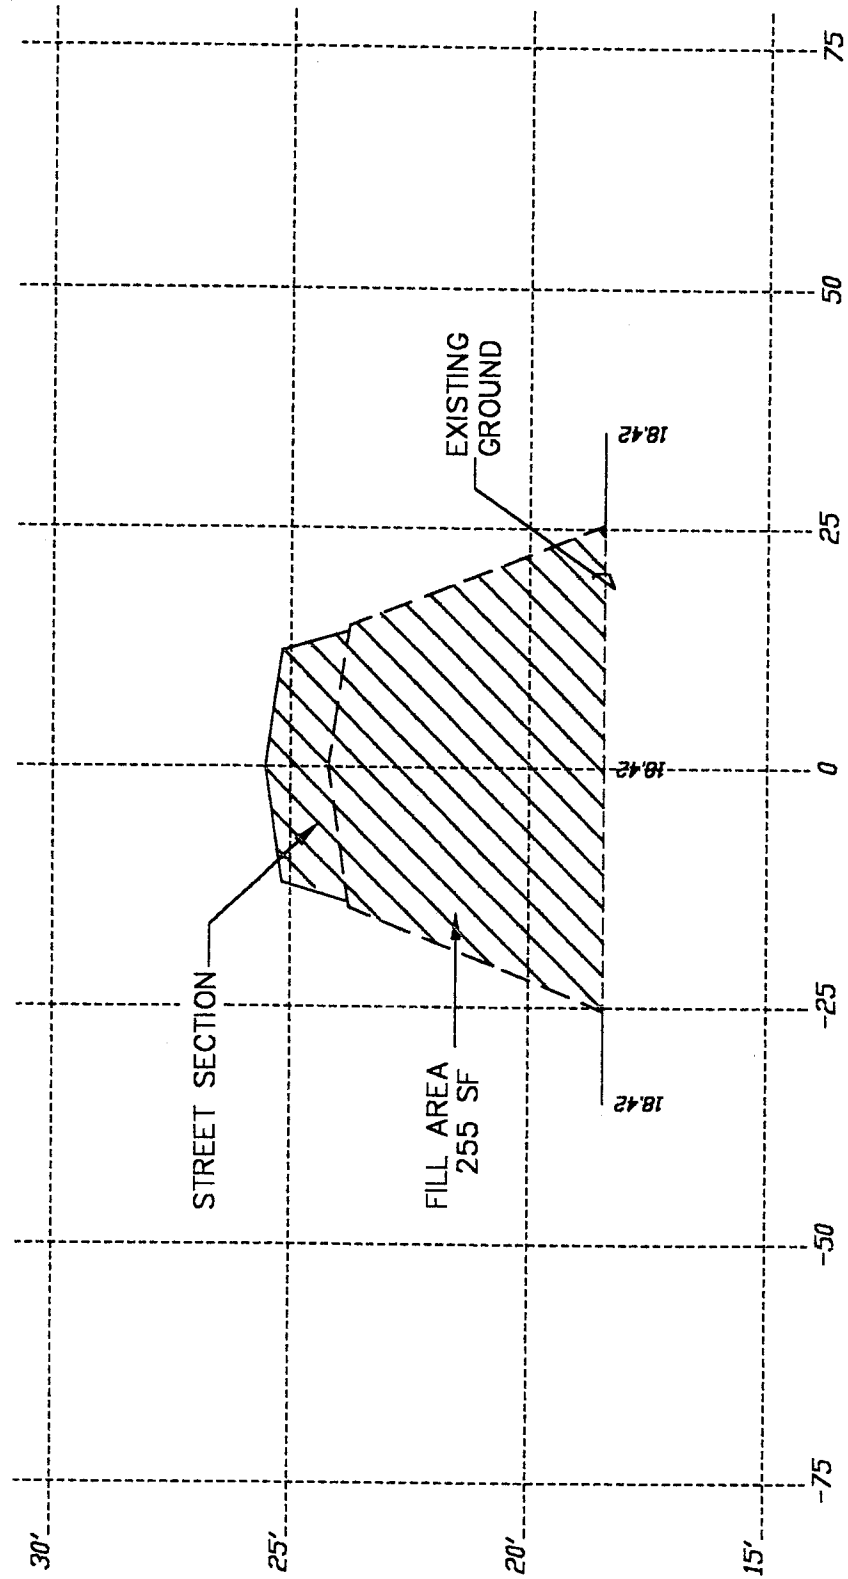


X-SECTION
KENNEDY PROPERTY
CLATSOP COUNTY, OR.
SHEET 4 OF 4 4B

PACIFIC BLVD.
STA 11+07

Copy #200400522

OCEAN BELLEVUE SUBDIVISION

CROSS-SECTIONS FOR
WETLAND PERMITS
APRIL 3, 2004

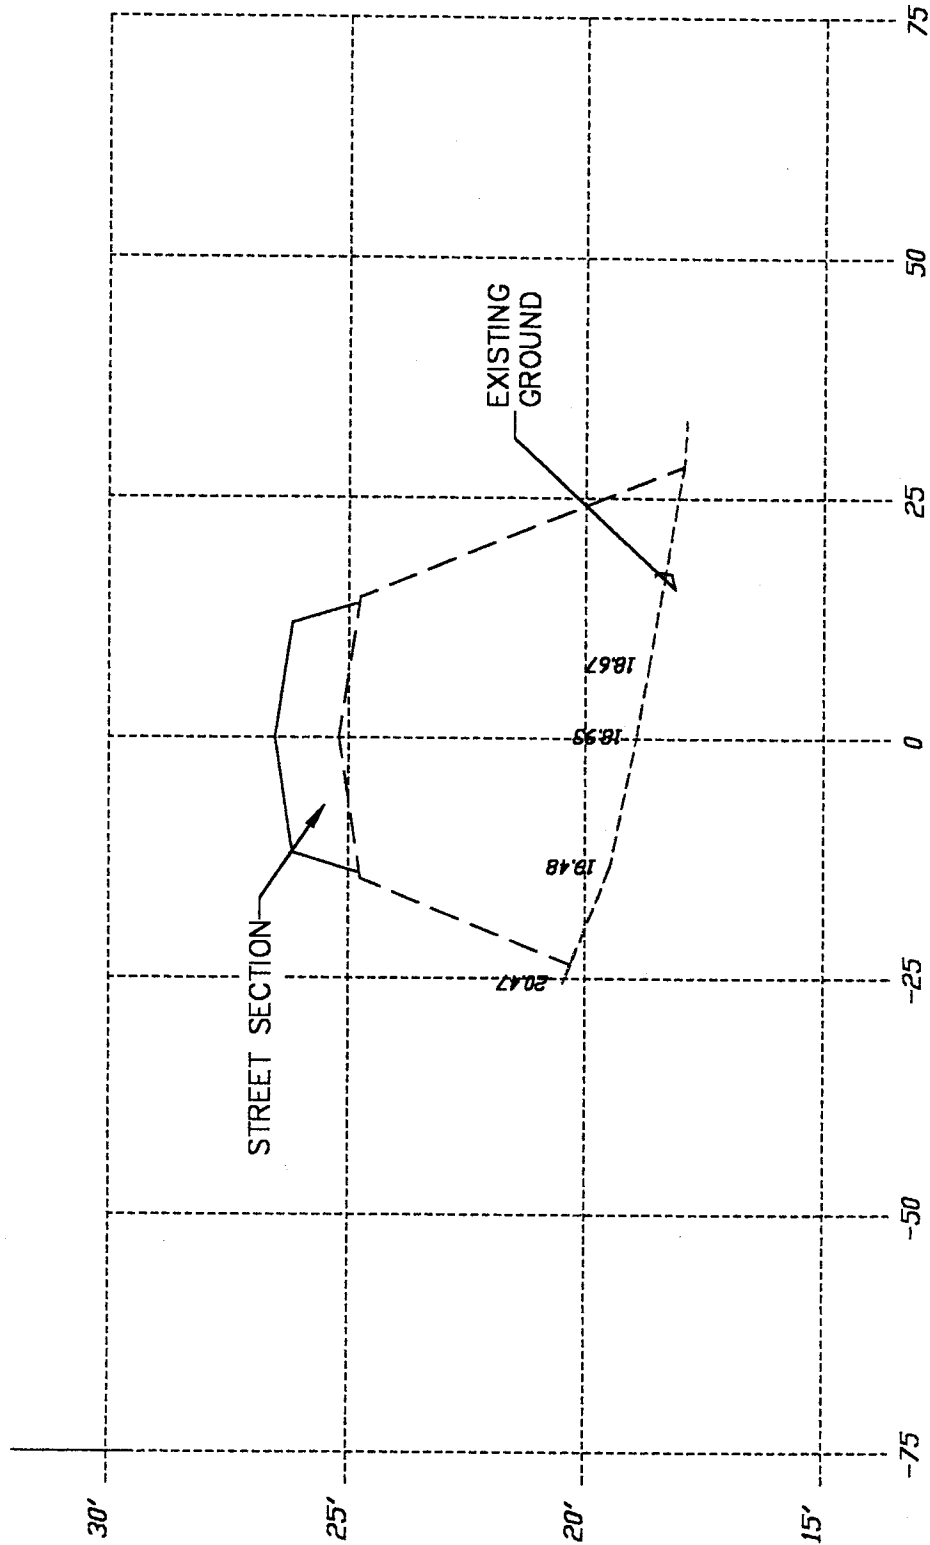


X-SECTION
KENNEDY PROPERTY
CLATSOP COUNTY, OR.
SHEET ~~1012~~ 4C

PACIFIC BLVD.
STA 12+00

Copy #200400522

OCEAN BELLEVUE SUBDIVISION

CROSS-SECTIONS FOR
WETLAND PERMITS
APRIL 3, 2004

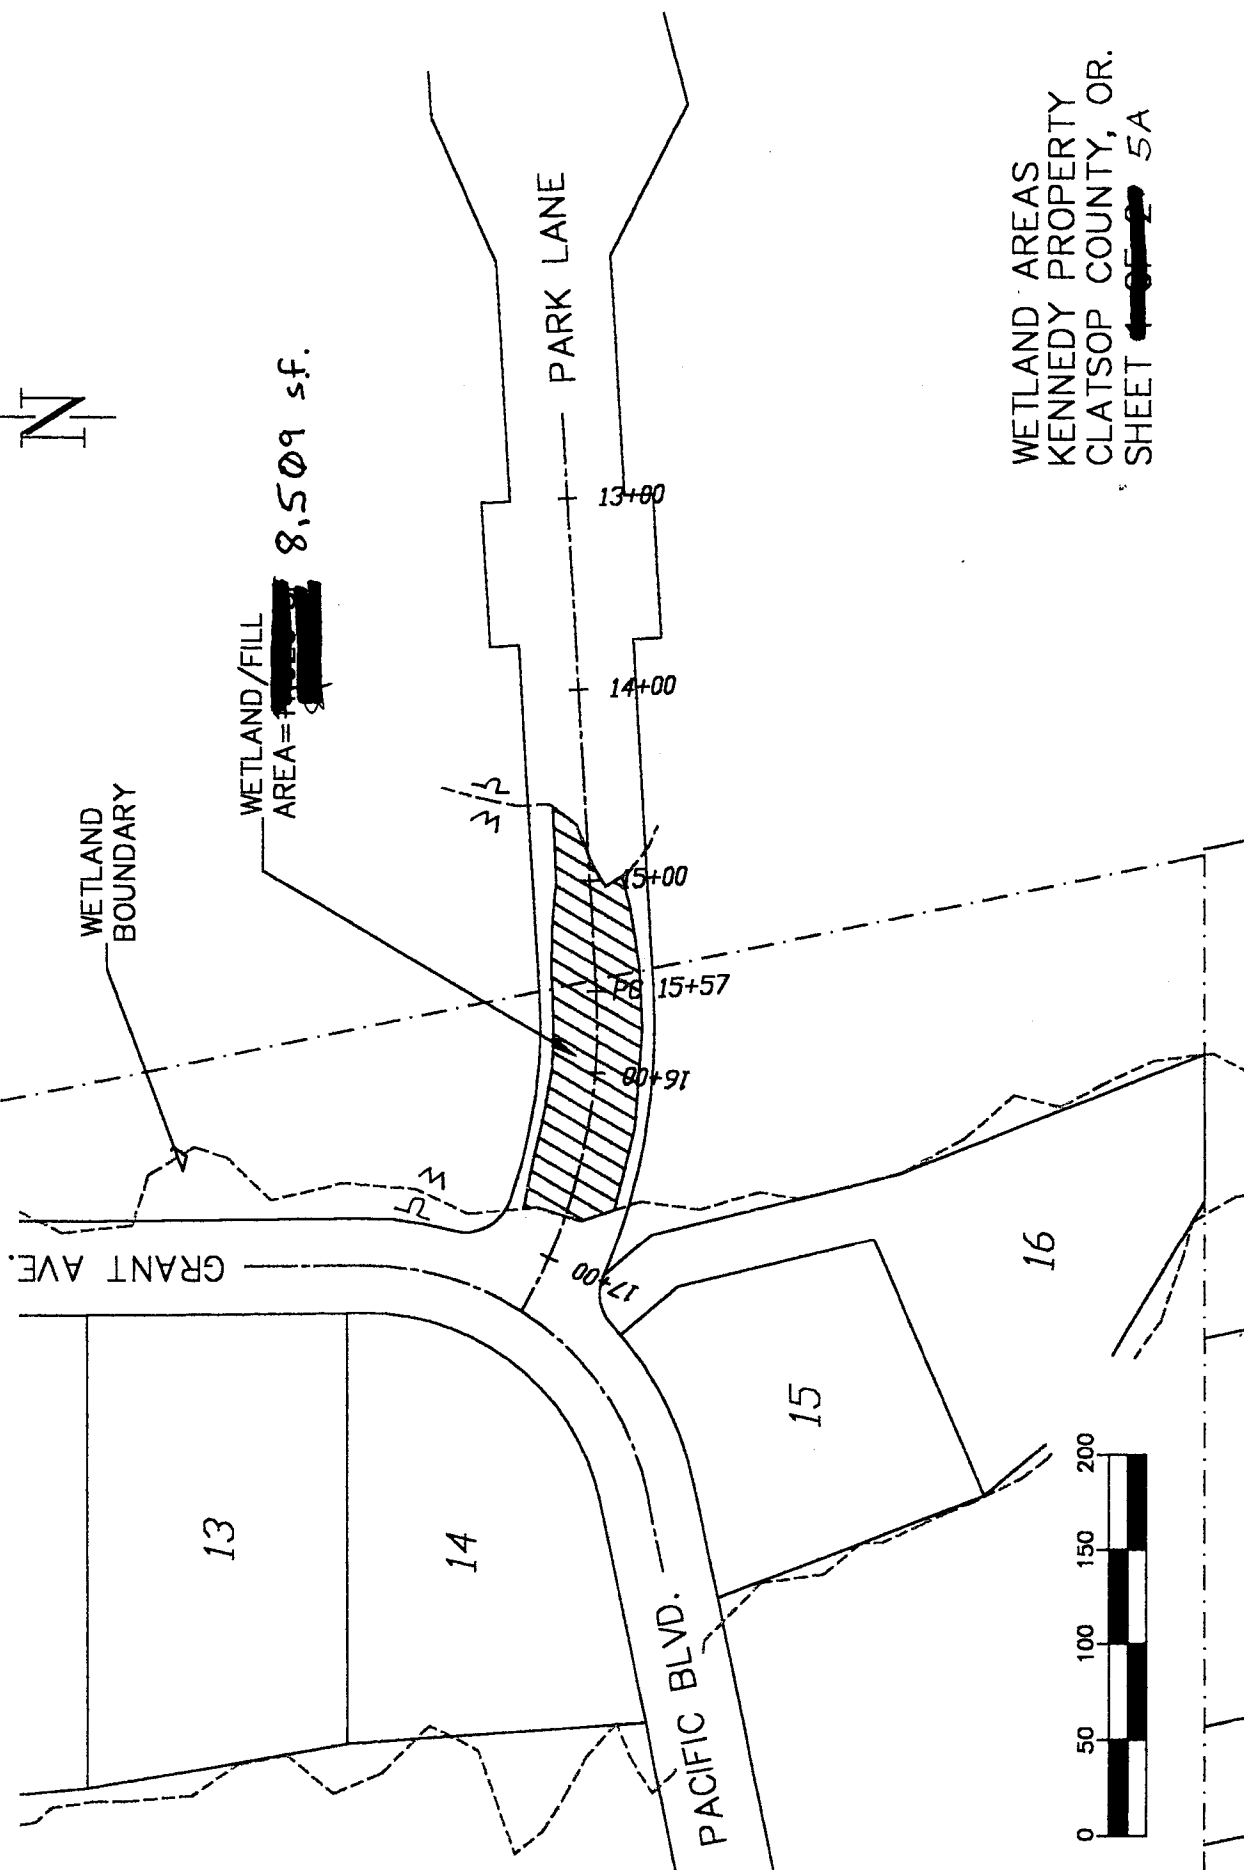


WETLAND AREAS
KENNEDY PROPERTY
CLATSOP COUNTY, OR.
SHEET ~~1 OF 2~~ 5A

Copy # 280400522

OCEAN BELLEVUE SUBDIVISION

CROSS-SECTIONS FOR
WETLAND PERMITS
APRIL 3, 2004

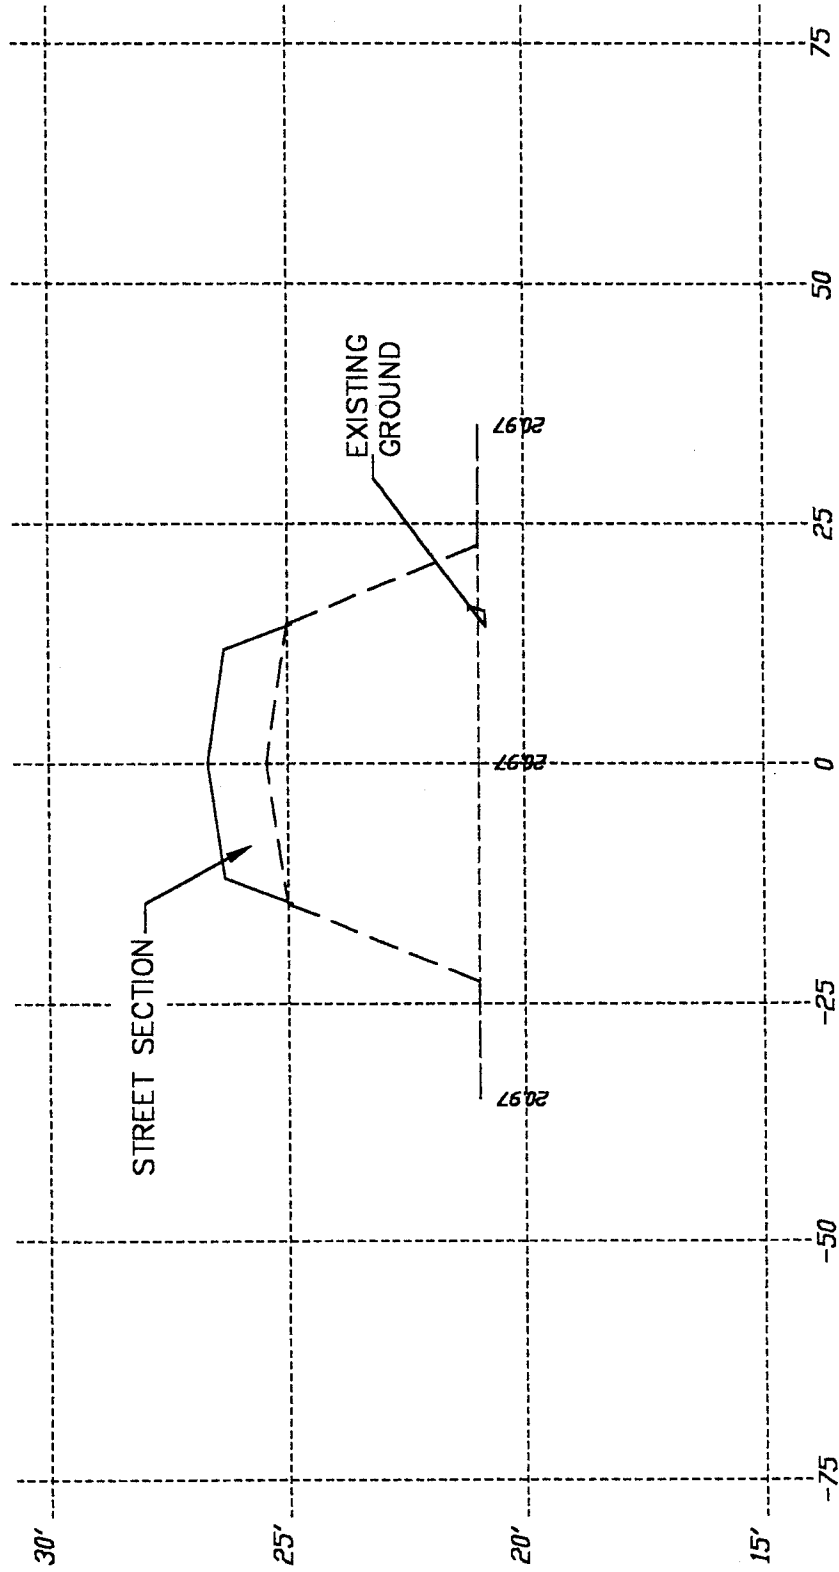

PARK LANE
STA 16+00

X-SECTION
KENNEDY PROPERTY
CLATSOP COUNTY, OR.
SHEET ~~107~~ 2 5B

Corpo#20040522

OPR

STATE OF OREGON

WEST

BK. 209, PG. 317

.09

OPR

LW

WETLANDS

N11°30'W 1290'

GRANT AVE.

WETLANDS

LW

PACIFIC BLVD

LW

OPR

WETLANDS

SCALE: 1" = 200'

PARK LANE

TAX LOT 901

1856 LOCATION
OF S.W. COR. OF
HOBSON D.L.C.

Sheet 6

3
4

5

6 STATE OF OREGON

7

8

Corps # 200400522

PUBLIC NOTICE
Oregon Department of Environmental Quality
Water Quality 401 Certification

Corps of Engineers Action ID Number: 200400522
Oregon Department of State Lands Number: 32892-FP

Notice Issued: September 23 2004
Written Comments Due: October 25, 2004

WHO IS THE APPLICANT: Andrew Kennedy

LOCATION OF CERTIFICATION ACTIVITY: See attached U.S. Army Corps of Engineers public notice

WHAT IS PROPOSED: See attached U.S. Army Corps of Engineers public notice on the proposed project

NEED FOR CERTIFICATION: Section 401 of the Federal Clean Water Act requires applicants for Federal permits or licenses to provide the Federal agency a water quality certification from the State of Oregon if the proposed activity may result in a discharge to surface waters.

DESCRIPTION OF DISCHARGES: See attached U.S. Army Corps of Engineers public notice on the proposed project

WHERE TO FIND DOCUMENTS: Documents and related material are available for examination and copying at Oregon Department of Environmental Quality, Water Quality Division, 811 S.W. 6th Avenue, Portland, Oregon 97204

While not required, scheduling an appointment will ensure documents are readily accessible during your visit. To schedule an appointment please call Alice Kavajecz at (503) 229-6962.

Any questions on the proposed certification may be addressed to the 401 Program Coordinator at (503) 229-5845.

PUBLIC PARTICIPATION:

Public Hearing: Oregon Administrative Rule (OAR) 340-48-0020 (6) states that "The Director shall provide an opportunity for the applicant, any affected state, or any interested agency, person, or group of persons to request or petition for a public hearing with respect to certification applications. If the Director determines that new information may be produced thereby, a public hearing will be held prior to the Director's final determination. Instances of doubt shall be resolved in favor of holding the hearing. There shall be public notice of such a hearing."

Written comments:

Written comments on the proposed certification must be received at the Oregon Department of Environmental Quality by 5 p.m. on (full date). Written comments should be mailed to Oregon Department of Environmental Quality, Attn: 401 Program Coordinator, 811 S.W. 6th Avenue, Portland, Oregon 97204. ***People wishing to send written comments via e-mail should be aware that if there is a delay between servers or if a server is not functioning properly, e-mails may not be received prior to the close of the public comment period.*** People wishing to send comments via e-mail should send them in Microsoft Word (through version 7.0), WordPerfect (through version 6.x) or plain text format to 401publiccomments@deq.state.or.us. Otherwise, due to conversion difficulties, DEQ recommends that comments be sent in hard copy.

WHAT HAPPENS NEXT: DEQ will review and consider all comments received during the public comment period. Following this review, the permit may be issued as proposed, modified, or denied. You will be notified of DEQ's final decision if you present either oral or written comments during the comment period. Otherwise, if you wish to receive notification, please call or write DEQ at the above address.

ACCESSIBILITY INFORMATION: This publication is available in alternate format (e.g. large print, Braille) upon request. Please contact DEQ Office of Communications and Outreach at (503) 229-5317 or toll free within Oregon at 1-800-452-4011 to request an alternate format. People with a hearing impairment can receive help by calling DEQ's TTY at (503) 229-6993.

PUBLIC NOTICE

OREGON COASTAL MANAGEMENT PROGRAM

CONSISTENCY CERTIFICATION

Date: September 23, 2004

Corps of Engineers Action ID Number: 200400522
Oregon Department of State Lands Number: 32892-FP

Notification

For projects subject to coastal zone review, notice is hereby given that the project is being reviewed by the Department of Land Conservation and Development (DLCD) as provided in Section 307(c) of the Coastal Zone Management Act. The applicant believes that the activities described in the attached materials would comply with and be conducted in a manner consistent with the Oregon Coastal Management Program. Project information can be made available for inspection at DLCD's Salem office.

DLCD is hereby soliciting public comments on the proposed project's consistency with the Oregon Coastal Management Program. Written comments may be submitted to DLCD, 635 Capital St. NE, Suite 200, Salem, OR 97301-2540, attention consistency review specialist. Any comments must be received by DLCD on or before the comment deadline listed in the federal notice. For further information, you may call DLCD at (503) 373-0050, ext. 250.

REVIEW CRITERIA

Comments should address consistency with the applicable elements of the Oregon Coastal Management Program. These elements include:

- Acknowledged Local Comprehensive Plans & Implementing Ordinances
- Statewide Planning Goals
- Applicable State Authorities (e.g. Removal-Fill Law and Oregon Water Quality Standards)

INCONSISTENT?

If you believe this project is inconsistent with the Oregon Coastal Management Program, your comments to DLCD should explain why you believe the project is inconsistent and should identify the Oregon Coastal Management Program element(s) in question. You should also describe how the project could be modified, if possible, to make it consistent with the Oregon Coastal Management Program.